

RECEIVED
TOWN CLERK
2022 FEB 28 A 11:03
FOXBOROUGH, MA 02035



THIS MAP IS FOR ASSESSMENT PURPOSES. IT IS NOT VALID FOR LEGAL DESCRIPTION OR CONVEYANCE.
THE HORIZONTAL DATUM IS THE MASSACHUSETTS STATE PLANE COORDINATE SYSTEM, NAD 83.
ORIGINAL MAPS PREPARED BY SOUTH SHORE DRAFTING SERVICE.

REVISED & REPRINTED BY
CAI Technologies
Precision Mapping, Geospatial Solutions.
11 Pleasant Street, Littleton, NH 03561
603.322.4540 - www.cai-tech.com

PARCEL AREA Ac/sf
RECORD DIMENSION 100'
SCALED DIMENSION 100%
MATCH LINE SEE SHEET No. 61
WATER W

LEGEND
PARCEL NUMBER 5
RIGHT OF WAY/ACCESS 600'
COMMON OWNERSHIP OR
WETLANDS W

SCALE: 1" = 80'
REVISD TO: JANUARY 1, 2021

PROPERTY MAPS
FOXBOROUGH
MASSACHUSETTS


INDEX DIAGRAM

1	2
4	5
10	11

MAP NO.
5

RECEIVED
TOWN CLERK

2022 FEB 28 A 11: 03
FOXBOROUGH, MA 02035

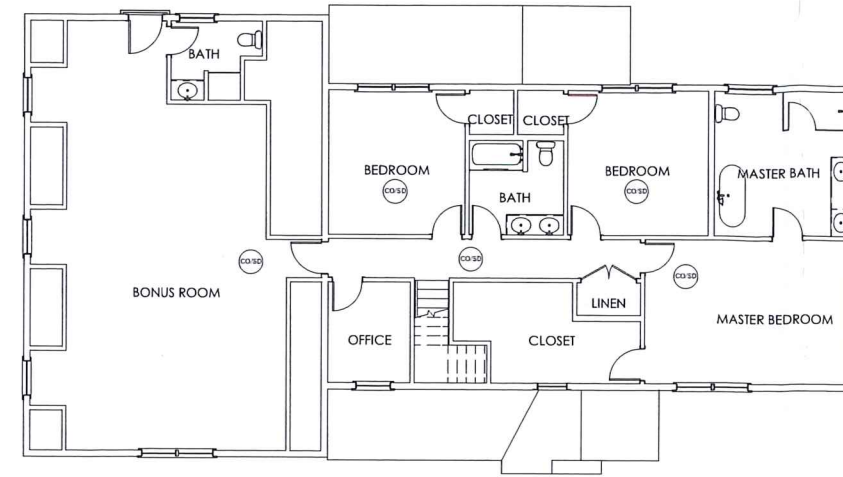

SECOND FLOOR LIVING SPACE: APPROX. 2200. PROVIDE MIN. 2 SMOKE ALARMS.

3 SECOND FLOOR FIRE PROTECTION PLAN
SCALE: 1/8" = 1'-0"


TLC Security
201 North ST
Employee Entrance

FIRE PROTECTION NOTES:

- FOLLOW ALL REGULATIONS AND REQUIREMENTS SET BY THE OFFICE OF THE MASSACHUSETTS STATE FIRE MARSHAL.
- ALL UNITS MUST BE HARDWIRED AND INTERCONNECTED. EACH UNIT TO HAVE BATTERY BACK-UP.
- A CARBON MONOXIDE DETECTOR MUST BE LOCATED WITHIN 10 FEET OF EACH BEDROOM DOOR.


UNIT TYPES:

- (CO-30) COMBINATION PHOTOELECTRIC SMOKE DETECTOR / CARBON MONOXIDE DETECTOR
- (HD) HEAT DETECTOR

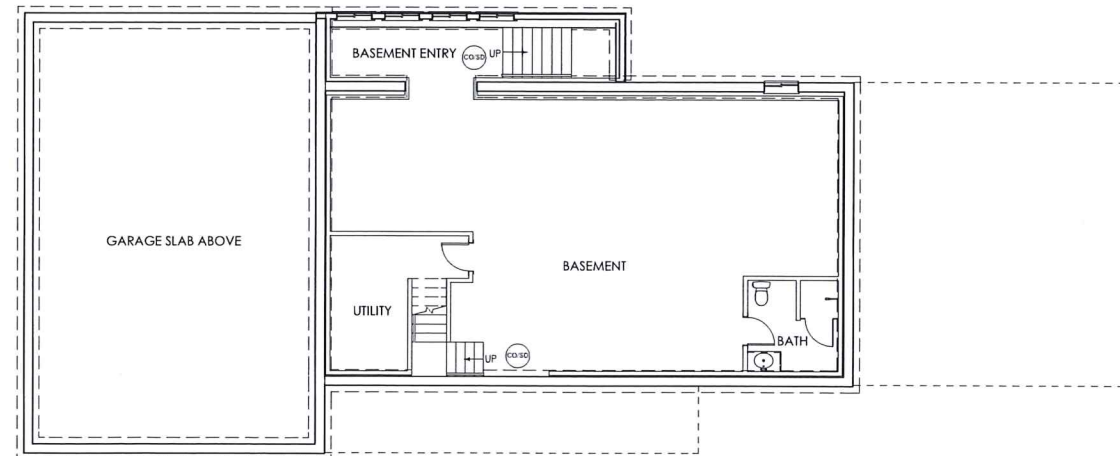

BASEMENT LIVING SPACE: APPROX. 1500. PROVIDE MIN. 2 SMOKE ALARMS.

1 BASEMENT FIRE PROTECTION PLAN
SCALE: 1/8" = 1'-0"

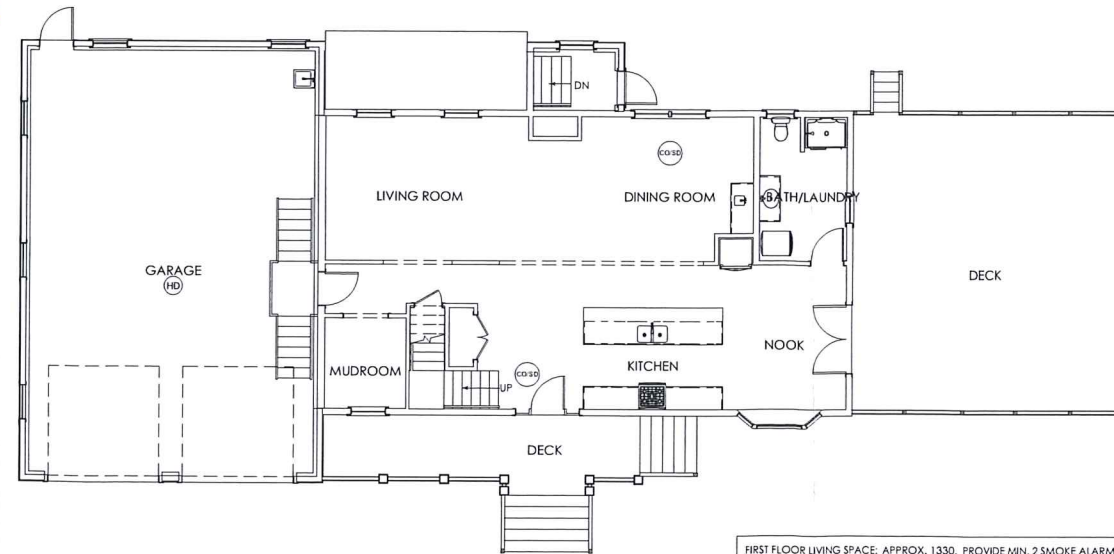

FIRST FLOOR LIVING SPACE: APPROX. 1330. PROVIDE MIN. 2 SMOKE ALARMS.

2 FIRST FLOOR FIRE PROTECTION PLAN
SCALE: 1/8" = 1'-0"

Sherry & Dasmid Alberly Residence
201 North Street, Foxborough, MA 02035

60 Pleasant Street, 10G
Ashland, MA 01721
617-513-8996
tricia@triciakendall.com

tricia kendall
Architecture + Design



Date:	Description:
12-04-20	75% As-Built Drawings
01-06-21	90% As-Built Drawings
03-29-21	95% As-Built Drawings
04-03-21	100% As-Built Drawings

Date:
4/3/2021

Sheet:

FP1

RECEIVED
TOWN CLERK
2022 FEB 28 A 11: 03
FOXBOROUGH, MA 02035

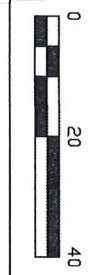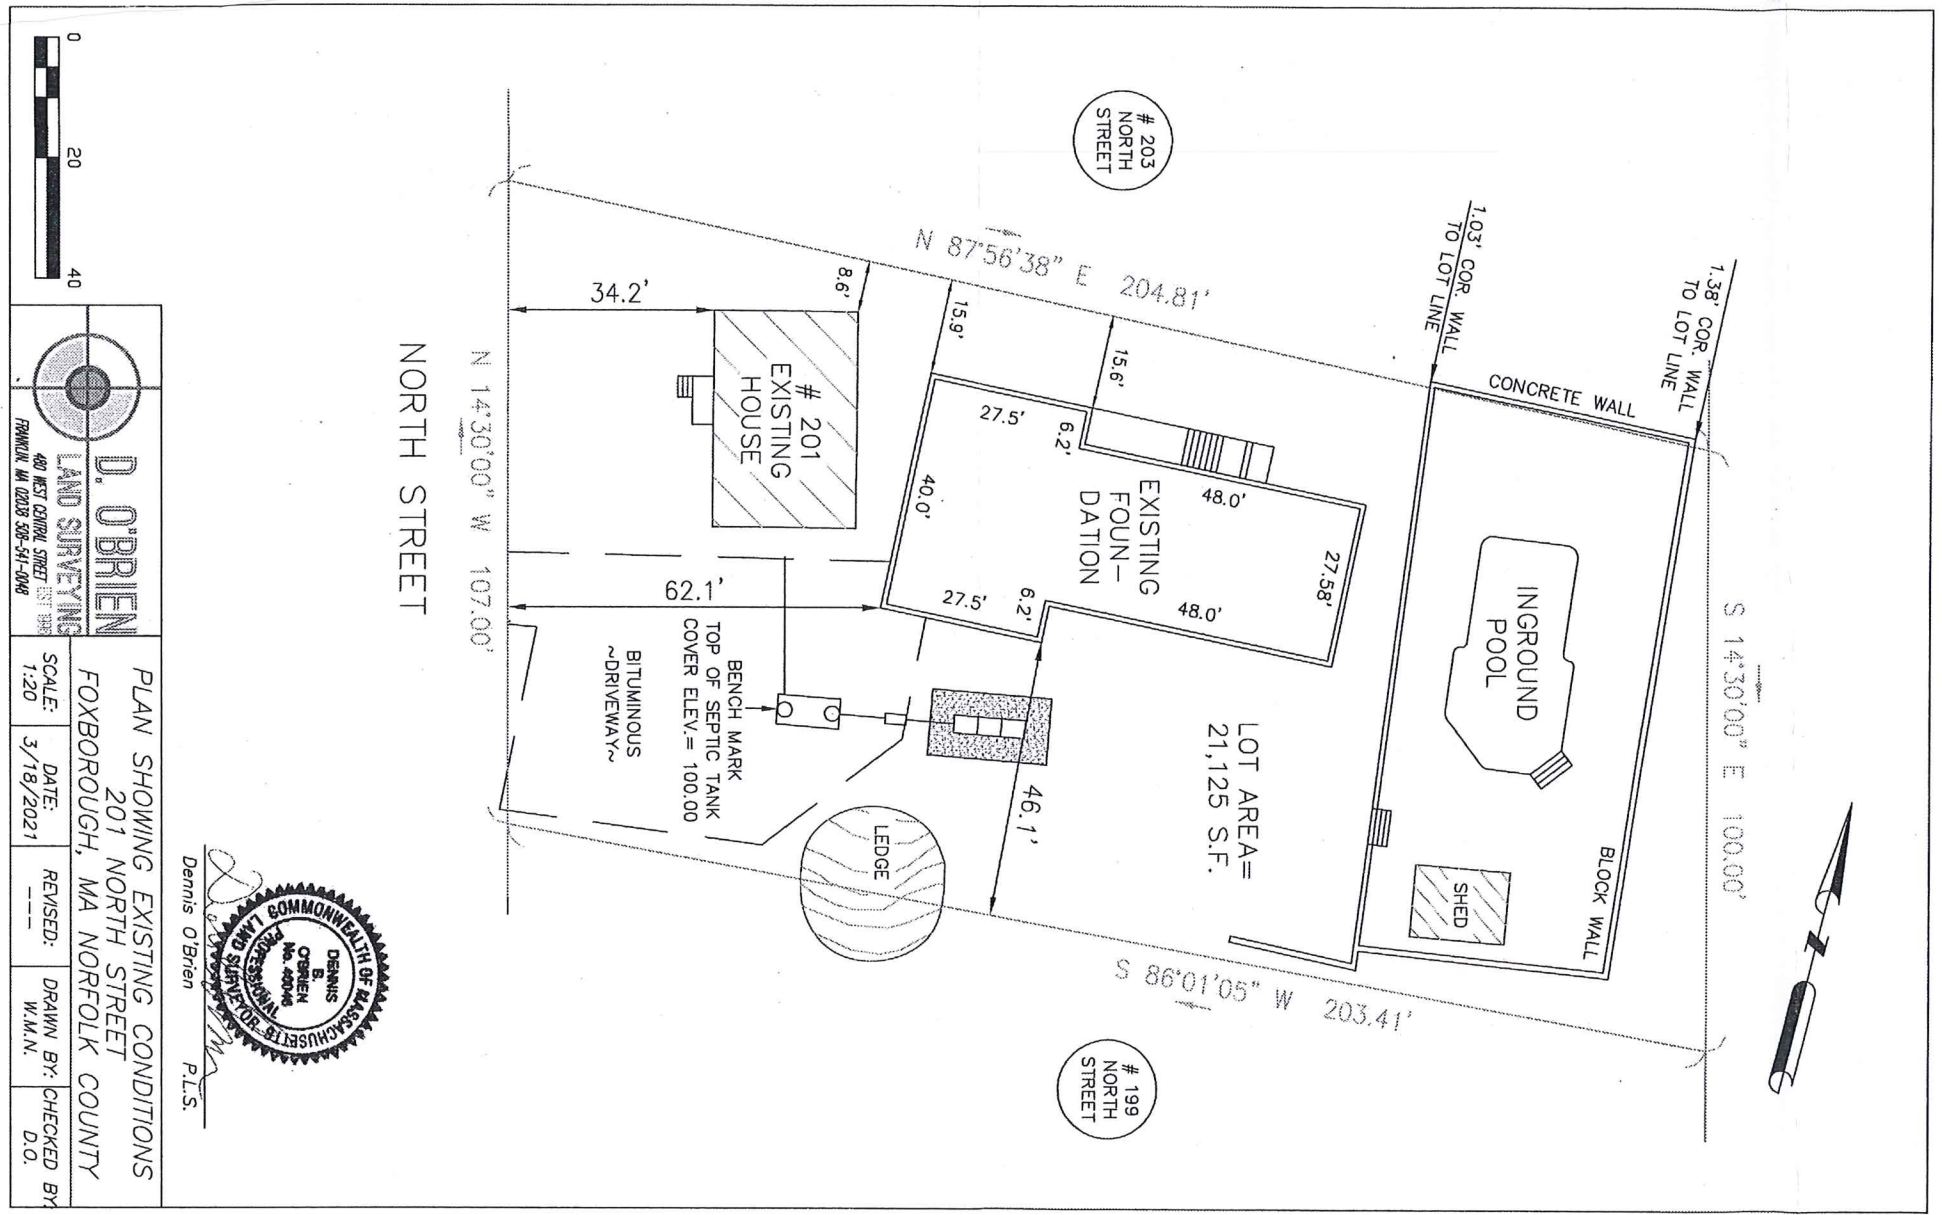

D. O'BRIEN
LAND SURVEYING
480 WEST CENTRAL STREET
FOXBOROUGH, MA 02035 508-541-0948

PLAN SHOWING EXISTING CONDITIONS
201 NORTH STREET
FOXBOROUGH, MA NORFOLK COUNTY

SCALE:	DATE:	REVISED:	DRAWN BY:	CHECKED BY:
1:20	3/18/2021		W.M.N.	D.O.

