


PREPARED FOR: LAMAR ADVERTISING  
360 WARREN AVENUE  
PROVIDENCE, RI 02914



Bay Colony Group, Inc.  
Professional Civil Engineers &  
Professional Land Surveyors

WASHINGTON STREET

WASHINGTON (public-var:width)  
(S.H.L.O. No. 7278-ROUTE 1)  
WASHINGTON (public-var:width)  
(S.H.L.O. No. 7278-ROUTE 1)

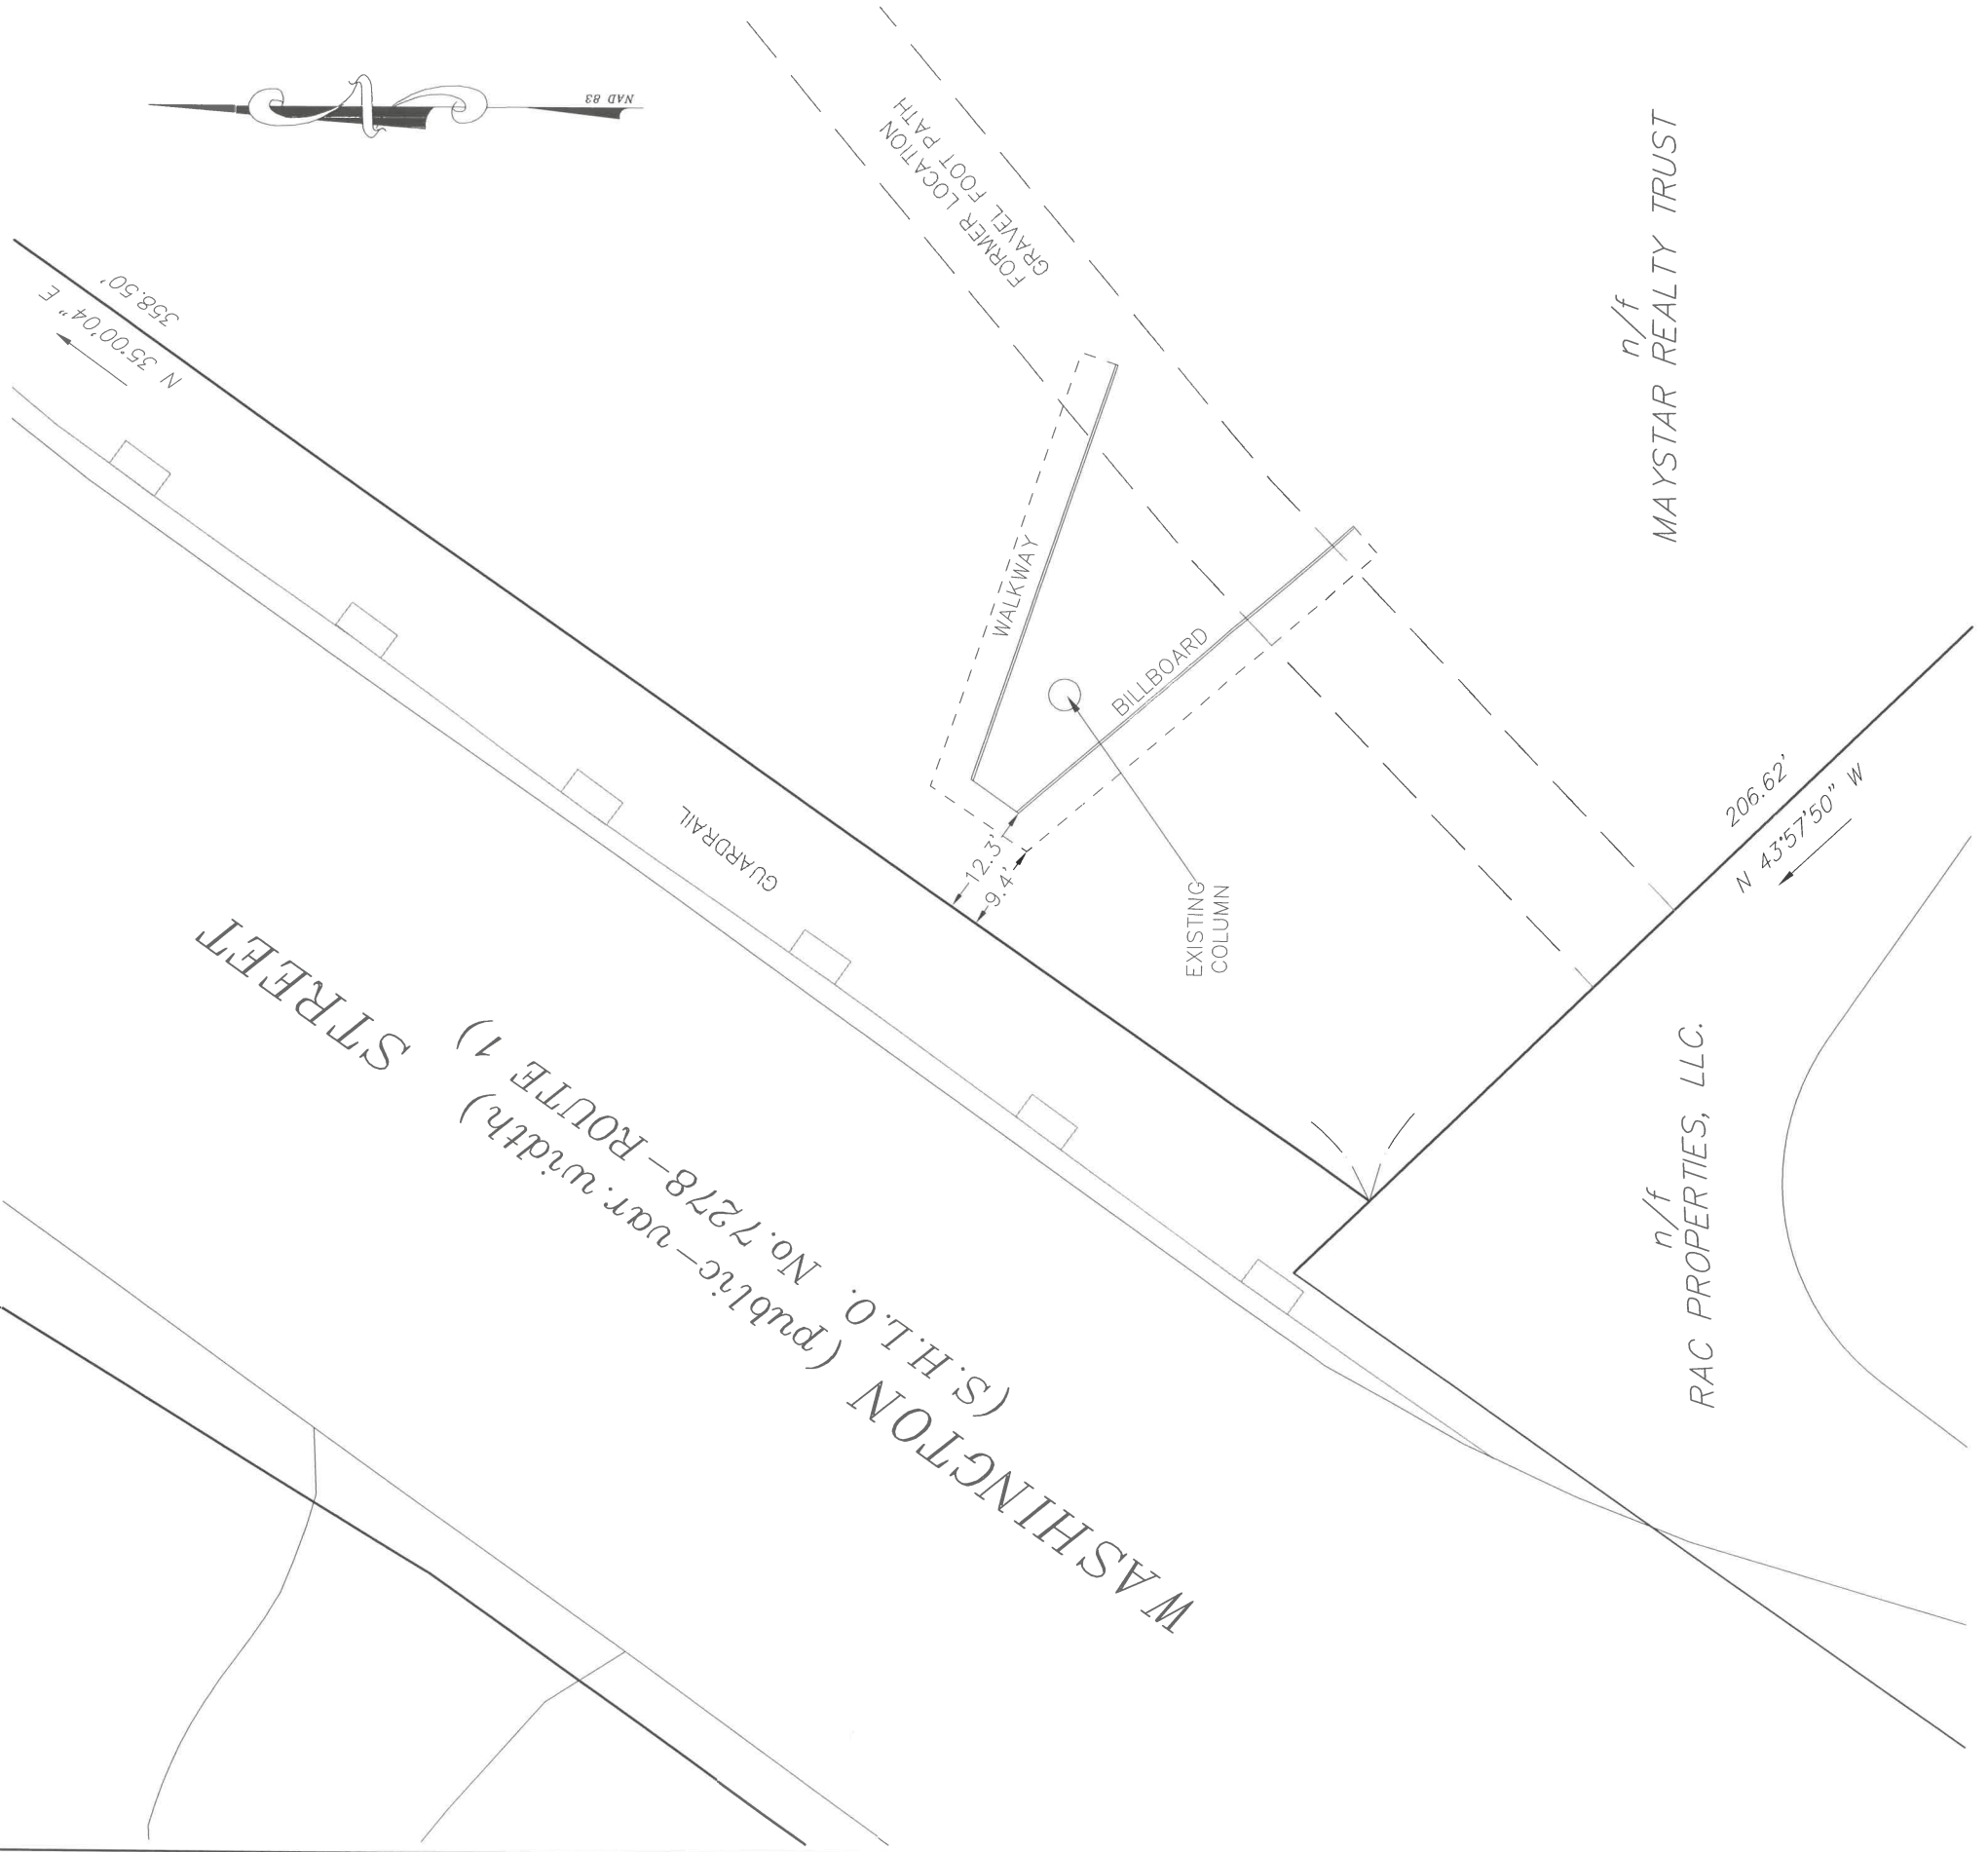

AS-BUILT BILLBOARD LOCATION  
PLAN OF LAND FOR  
124 WASHINGTON STREET  
FOXBOROUGH, MA



SEPT. 27, 2022 SCALE: 1" = 20'

BAY COLONY GROUP, INC.  
PROFESSIONAL CIVIL ENGINEERS & LAND SURVEYORS  
FOUR SCHOOL STREET, P.O. BOX 9136  
FOXBOROUGH, MA 02035  
(508) 543-3939

I hereby certify to the Foxborough Building Commissioner that to the best of my professional knowledge, information, and belief that the existing billboard is located on the ground as shown hereon.